




MOUZA-SIJA, J.L NO-227, P.S - ~~SADRA PUR~~, DIST- BIRBHUM.

SCALE 1" = 22'

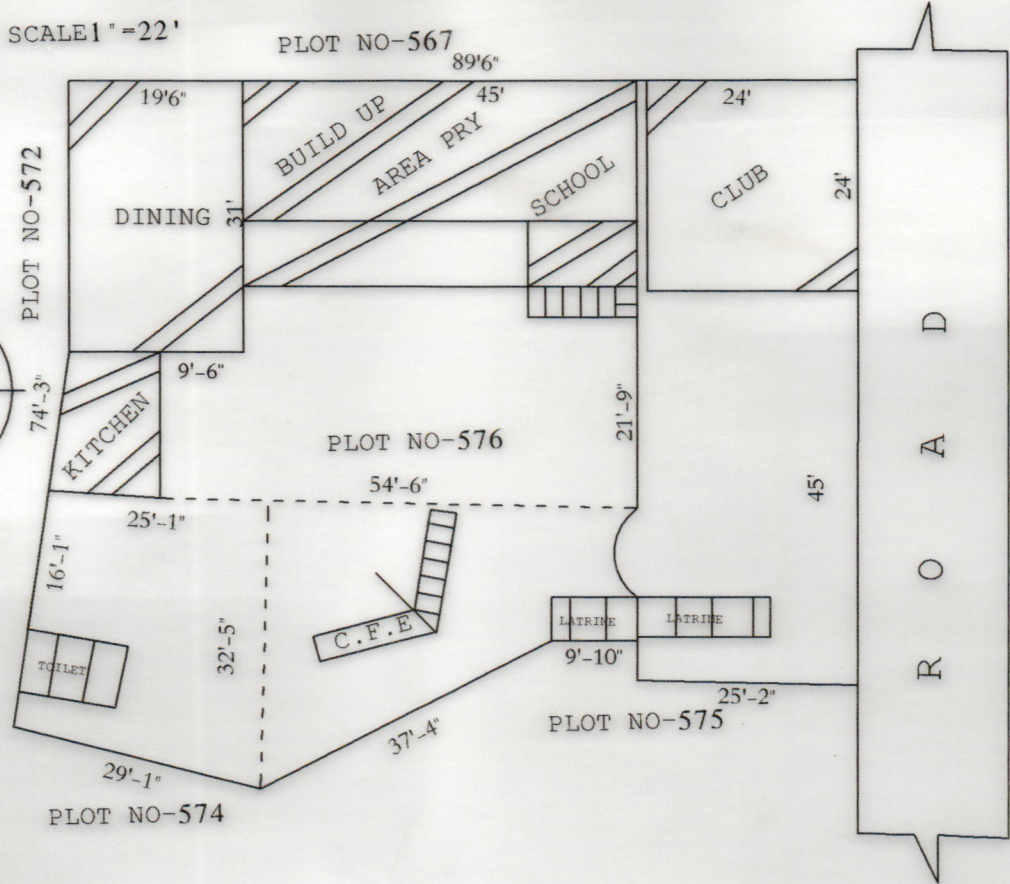

SCHEDULE

*SIJA*

SCHOOL NAME - ~~K~~KADDANG KABINAZRUL PRY SCHOOL.

DISE CODE :-19081011201

CIRCLE :-DUBRAJPUR SOUTH.

BLOCK: ~~DUBRAJPUR~~.

PANCHAYAT:- ~~SADRA PUR~~.

MOUZA:-SIJA.

J.L NO:-227

PLOT NO :-576.

KHATIAN NO :-08

AREA OF LAND:-6598 SFT.-0.15146 ACRE.

USABLE AREA -2692 SFT.

FALLOW AREA- 3906.

AREA OF ANG.CENTAR - NIL.

AREA OF UPPER PRY -NIL.

*SK Anamul Haque* 26/05/15

SELE & SIG. OF H.T.

*Head Teacher*

SIJA - KADDANG  
K. N. PRY. SCHOOL  
P.O.- Jatra, Birbhum

*Buddhader son*

Signature of Amin

22.05.15