


MOUZA - PATHAI ; J. L. NO - 10 ; P. S. - MAYURESWAR ;
DIST - BIRBHUM. (ON POSSESSION MEASUREMENT)

SCALE - 33'-0" = 1"

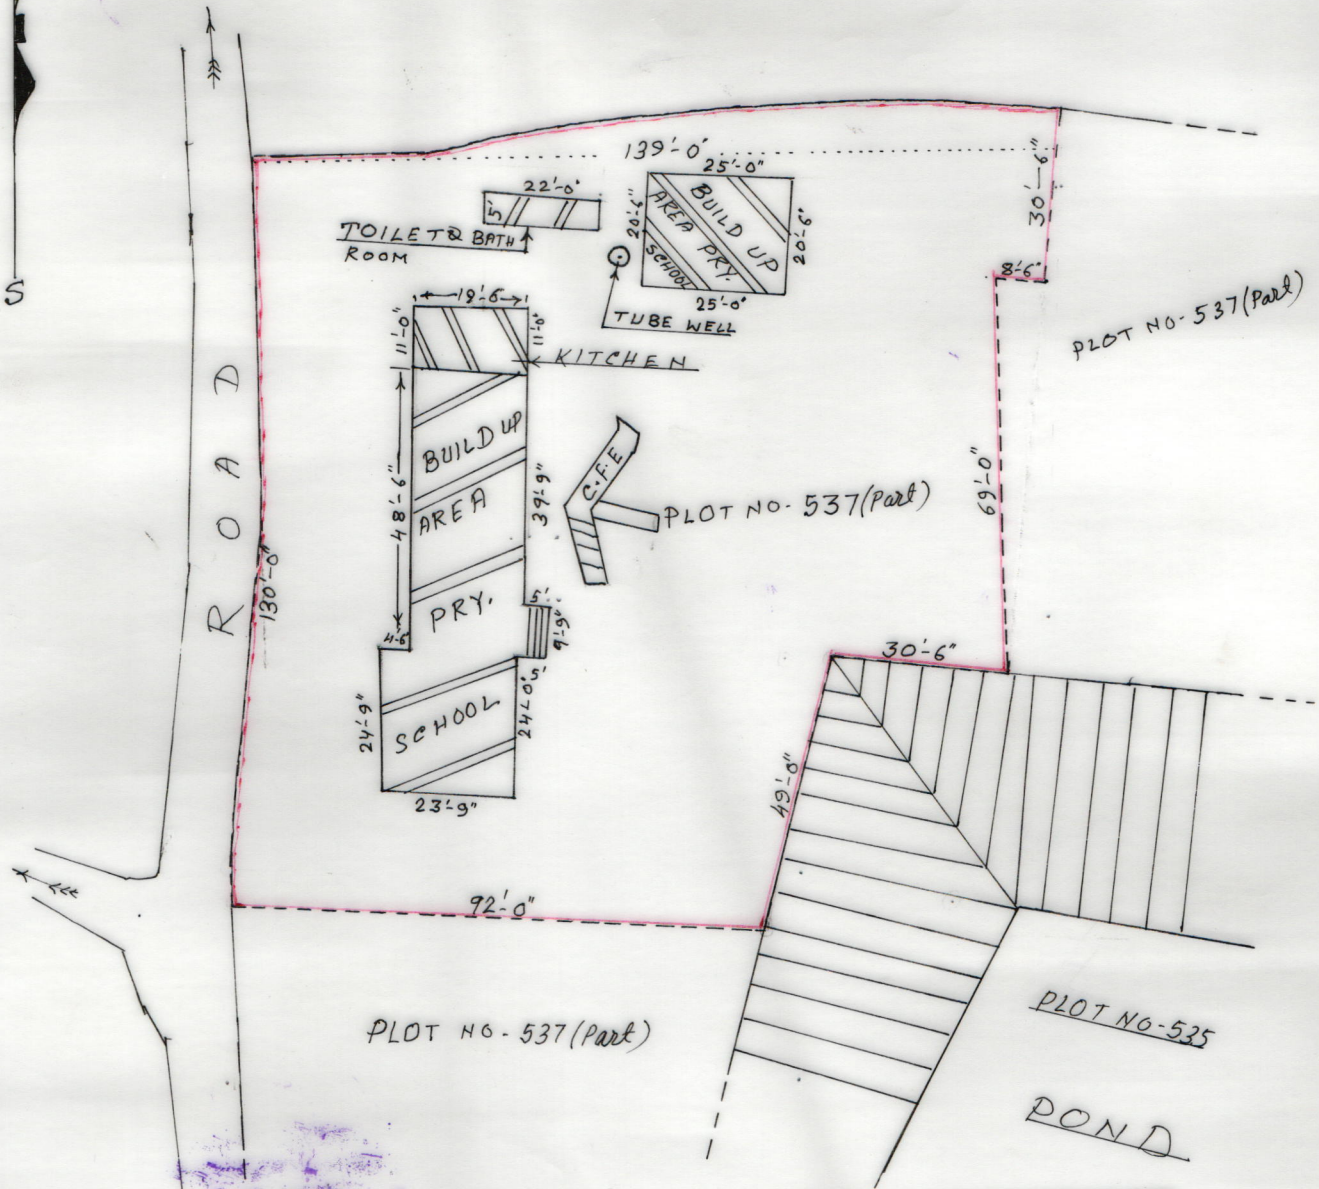

SCHEDULE

SCHOOL NAME :-	PATHAI PRY. SCHOOL
DISE CODE :-	1908100303
CIRCLE :-	MALLORPUR
BLOCK :-	MAYURESWAR (i)
PANCHAYET :-	BAJITPUR
MOUZA :-	PATHAI
J. L. NO :-	10
PLOT NO :-	537 (Part)
KHATAN NO :-	680
AREA OF THE LAND :-	16552.8 SQ F.T. = 0.38 ACRE
USABLE AREA =	2657.00 SQ F.T
FALLOW AREA :-	13896.00 SQ F.T

Rashee Mahan Banerjee
27.5.2015

SEAL & SIGNATURE OF H. T.

REMARKS :- MEASURE AREA IS RED INK MARKED SHOW THUS SURVEYED & DRAWN BY

Blind signature,
Pathai Pry. School
P.O. PATHAI
Dist. Birbhum

P. J. Kanti Sen
SURVEYOR
Govt. Reg. No. - 1095
Jasoda • Gorola • Birbhum